

DATED

26th April

2016

**THE BOROUGH COUNCIL OF GATESHEAD**

---

**PUBLIC PATH EXTINGUISHMENT ORDER**

---

Relating to the extinguishment of Footpath ~~14 and 15~~

Mike Barker  
Strategic Director of Corporate Services and Governance  
Gateshead Council  
Regent Street  
Gateshead  
NE8 1HH

Ref: TH/1557

# **PUBLIC PATH EXTINGUISHMENT ORDER**

## **HIGHWAYS ACT 1980**

### **THE BOROUGH COUNCIL OF GATESHEAD**

#### **THE BOROUGH COUNCIL OF GATESHEAD (FOOTPATHS ~~FELLING 14~~ ~~AND 15~~)**

### **PUBLIC PATH EXTINGUISHMENT ORDER 2016**

This order is made by The Borough Council of Gateshead ('the authority') under section 118 of the Highways Act 1980 because it appears to the authority that the footpaths described in paragraph 1 and the Schedule below are not needed for public use.

#### **BY THIS ORDER:**

1. The public right~~s~~ of way over the land situate at Bill Quay, and shown by continuous bold line~~s~~ on the map attached to this order shall be extinguished after 7 days from the date of confirmation of this order.

### **SCHEDULE**

#### **Footpath Felling 14**

From Point A on the order map grid reference NZ29666275 approximately 40 metres east of Joel Terrace and approximately 65 metres north of Brack Terrace, Footpath Felling 14 then proceeds in a north easterly direction before turning north to its junction with Footpath Felling 16 at Point B on the order map grid reference NZ29776296, for a distance of approximately 250 metres, with an undefined width throughout.

#### ~~**Footpath Felling 15**~~

~~From Point B on the order map grid reference NZ29776296 from its junction with Footpath Felling 16, Footpath Felling 15 proceeds in a south easterly direction for approximately 98 metres to its junction with the tarmac path, which runs to the rear of Marion Drive at Point C on the order map grid reference NZ29856290, with an undefined width throughout.~~

THE COMMON SEAL of the BOROUGH  
COUNCIL of GATESHEAD was hereunto  
affixed in the presence of:-



2016/206

Mayor

*CACpddos*


Solicitor to the Council

*JA HW*

The foregoing order is hereby confirmed  
subject to the red ink modifications thereon

*Helen Heward* 17 MAY 2017

An Inspector appointed by The Secretary  
of State for Environment, Food and  
Rural Affairs

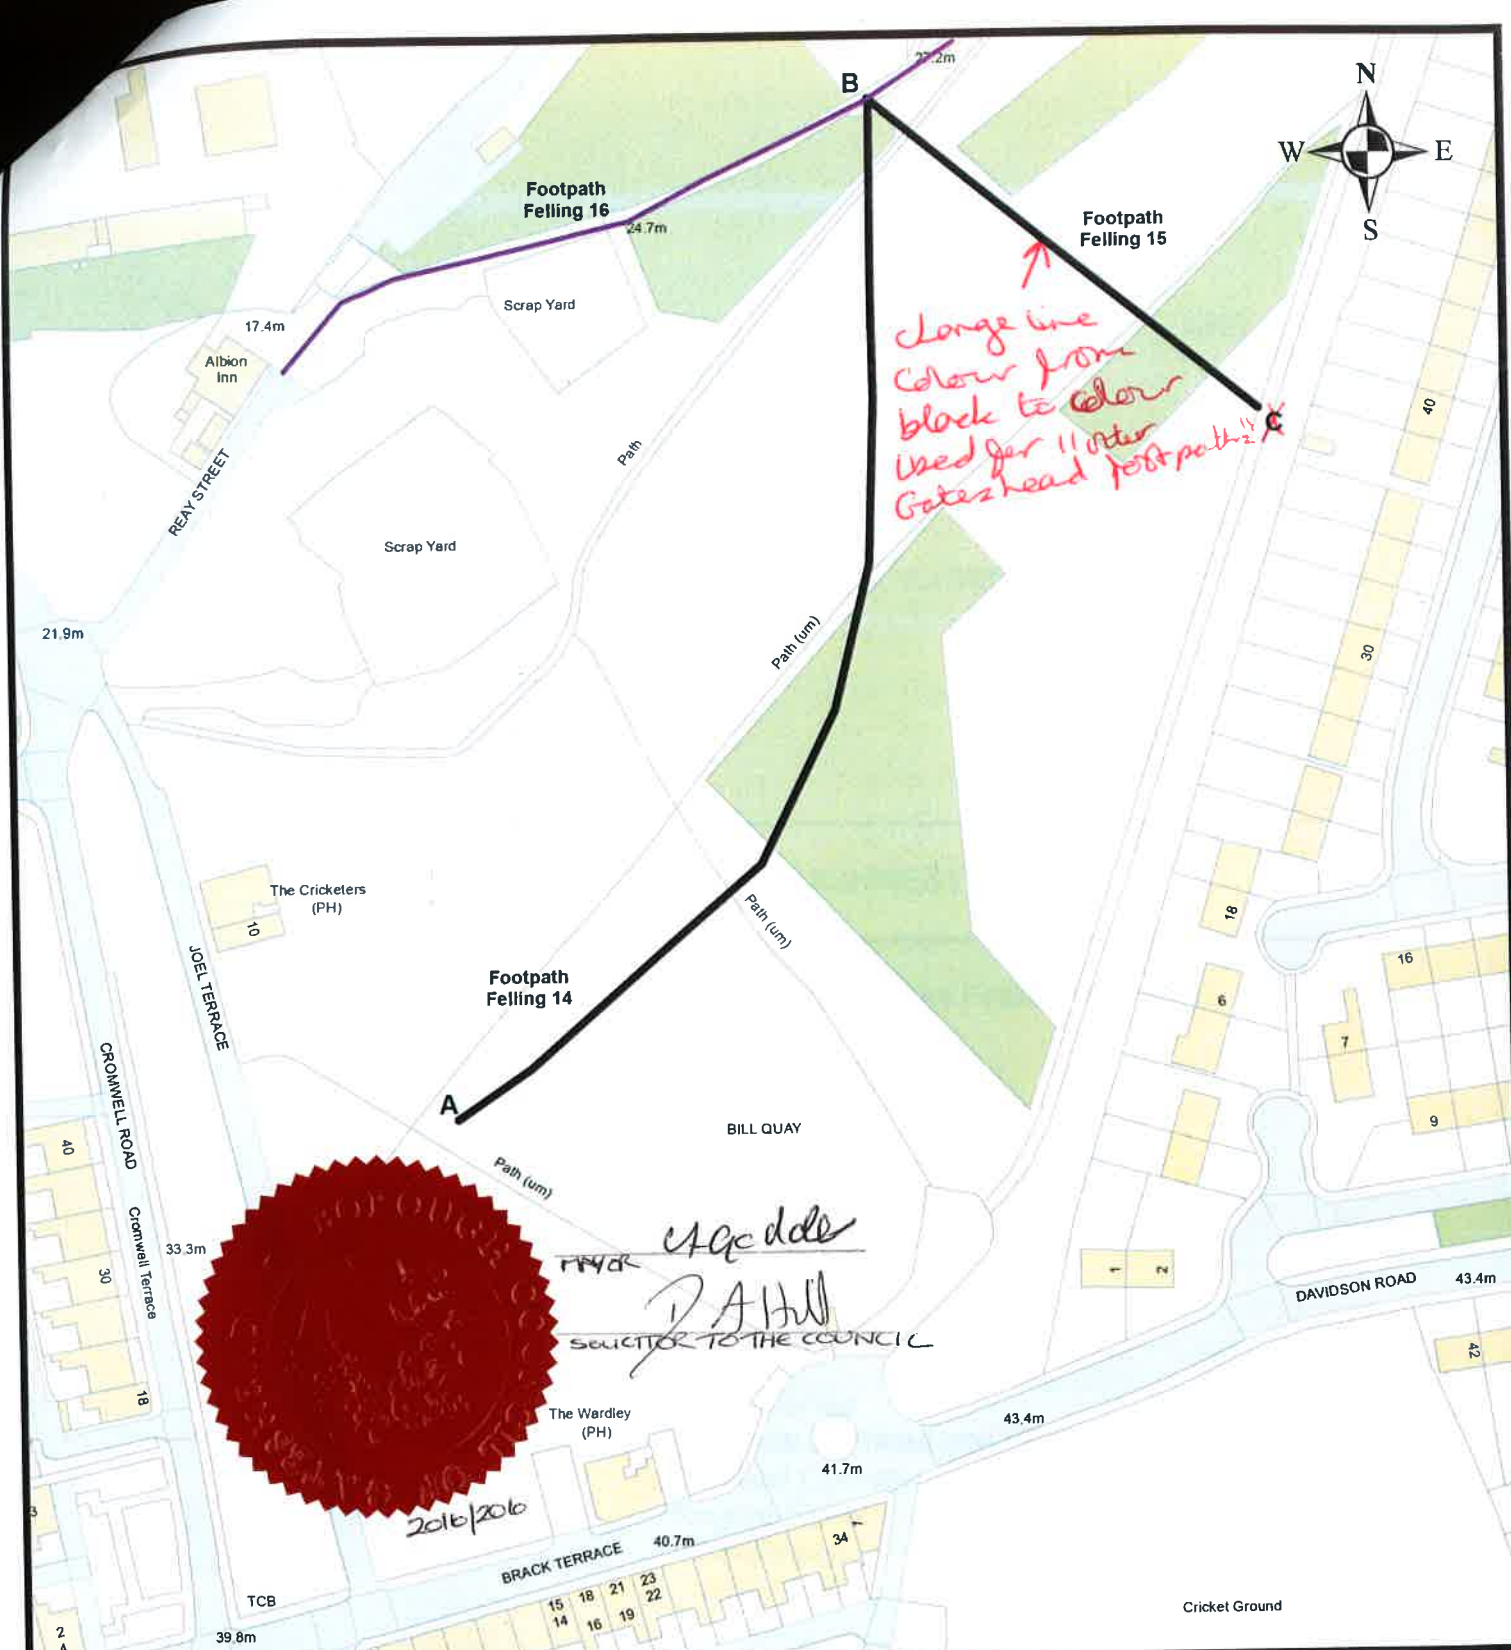

# Extinguishment of Footpaths Felling 14 and Felling 15 Bill Quay, Gateshead.

Footpaths to be Extinguished

Felling 14 A - B

Felling 15 B - C

Other Gateshead  
Footpaths

Scale 1: 1500

(at A4)



© Crown copyright and database rights  
2015 Ordnance Survey Gateshead Council  
100019132